


"SHOWA MARU" GENERAL ARRANGEMENT

SCALE 1 : 200



PR
LENGTH
BREADTH
DEPTH
DEADWEIGHT
GROSS TON
NET TON

UPPER
TUN
610
FRAME SPACE
CHAIN
LOCKER

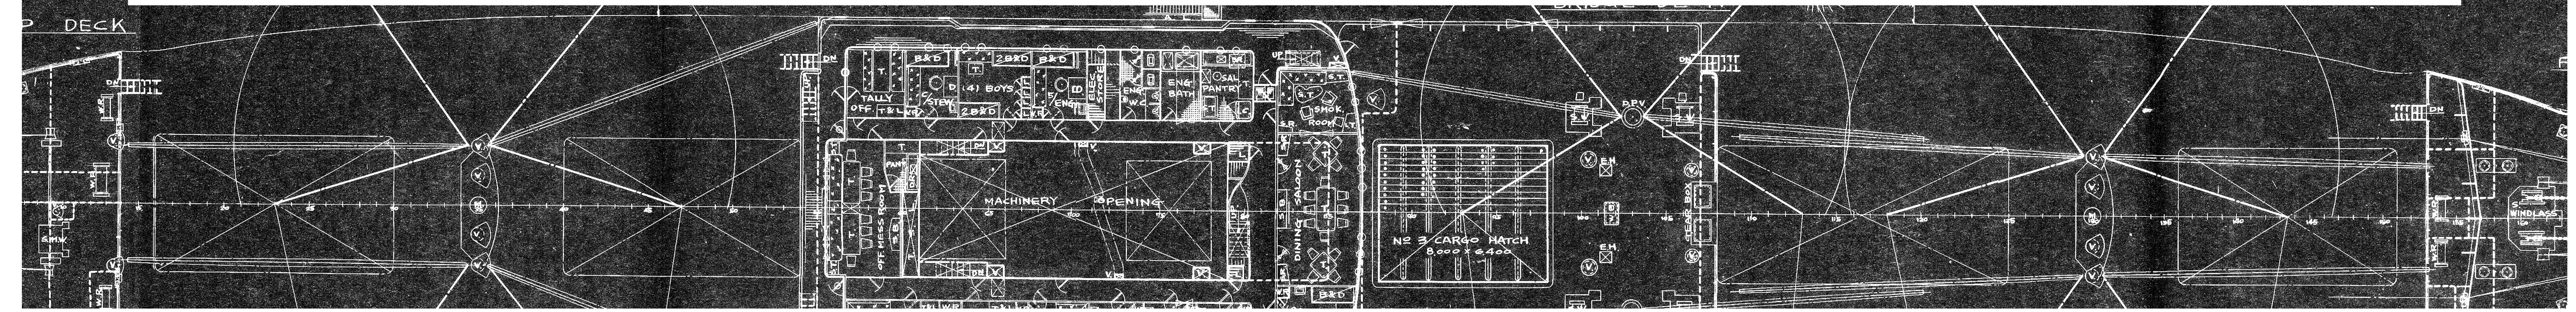

NO 650
昌和丸

GENERAL
ARRANGEMENT

一般配置

完成圖

SCALE 1:200



類別番號 完成-17

01352-011359-0074


★ Showa Maru
"as built"

yka F.E. Rpt. No. 1162A.



General arrgt

RECORDS DEPT.
LONDON

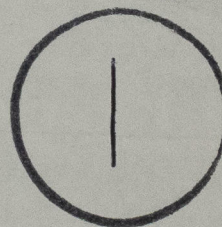

© 2021

Lloyd's Register
Foundation

011352-011359-0074

<u>PRINCIPAL DIMENSIONS</u>	
LENGTH B.P	128'11
BREADTH MLB	17'00
DEPTH MLB	10'40
DEADWEIGHT	10,104.5
GROSS TONNAGE	6628.27
NET TONNAGE	3713.36



營社調製

1. 昭和28年2月 日 D N O C-2229
とい基本設計課に於て計画
2. 昭和28年4月13日 S N O C50
とい設計課に於て調製
3. 昭和28年7月15日 敍主要求に
依り一部改正出圖
4. 昭和28年9月11日 敍主要求に
依り第二回改正出圖
5. 昭和28年11月10日 完成回調製

HEIGHT OF DECKS	
UPPER DECK TO 2ND DECK AT CENT	3.300
UPPER DECK TO 2ND DECK AT SIDE	3.000
UPPER DECK TO BRIDGE DECK	2.400
UPPER DECK TO FILE DECK	2.300
UPPER DECK TO POOP DECK	2.300
BRIDGE DECK TO BOAT DECK	2.350
BOAT DECK TO CAPTAIN DECK	2.350
CAPTAIN DECK TO NAV DECK	2.350
NAV DECK TO COMP DECK	2.300

-# OF CREW			
CAPTAIN	1	CHIEF ENG	1
CHIEF OFF	1	1ST ENG	1
2ND OFF	1	2ND ENG	1
3RD OFF	1	3RD ENG	1
APPRENT	1	4TH ENG	PURSER
		5TH ENG	DOCTOR
		APPRENT	CLERK
SPARE	1	SPARE	CUST OFF
	6		17
BOSS	1	NO. 1 OIL	CHIEF STEW
CARPENT	1	NO. 1 OIL	COOK
S. K.	1	S. K.	BOY
Q. M.	4	OILER	2
SAILER	8	D. M.	3
	15	WIPER	5
	21	15	17
	21	21	14
TOTAL CREW			56
GRAND TOTAL			70

GENERAL ARRANGEMENT

一般配置

類別番號 完成-17